
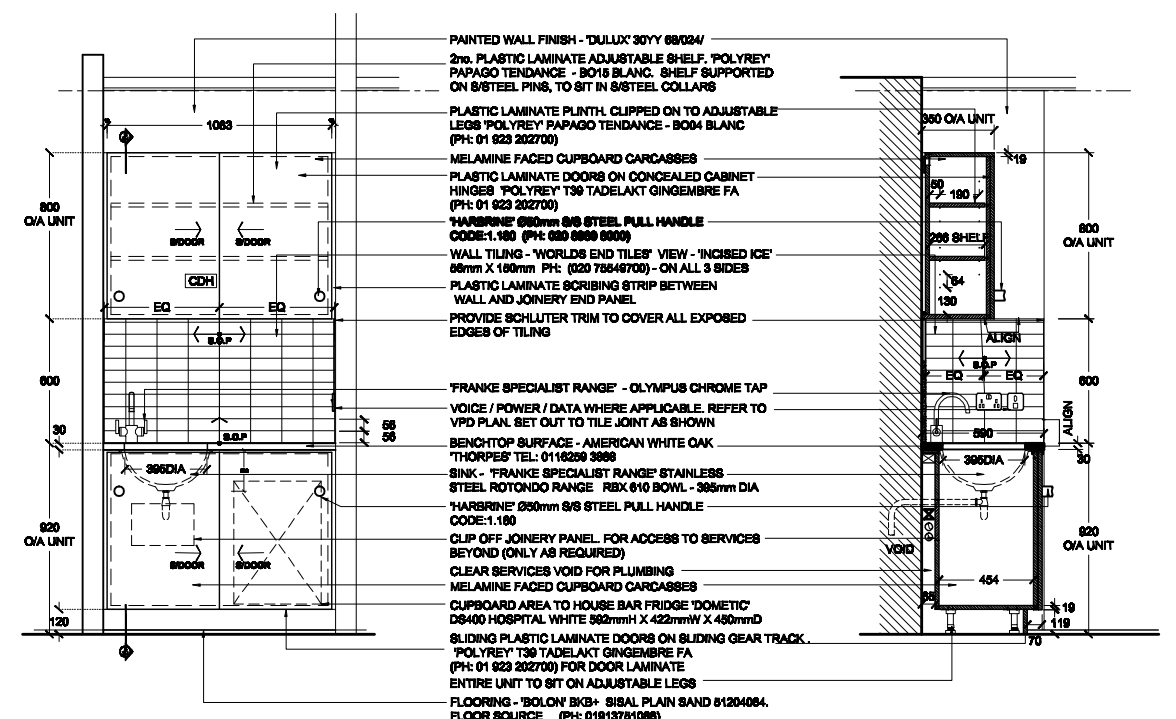
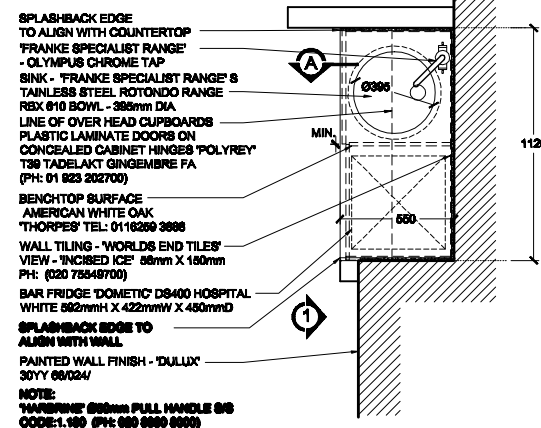


- WC** CHLOE CC CLOSE COUPLED WC SUITE
MANF: ARMATAGE SHANKS
SPEC: E2660 CHLOE WC PAN WITH HORIZONTAL OUTLET, E7807 PUSH BUTTON DUAL FLUSH VALVE CISTERN, E2631 CHLOE BEAT & COVER WITH STAINLESS STEEL HINGES, VITREOUS CHINA
(PH: 01643490253)
- WHB** TULIP 48 WASH BASIN
MANF: ARMATAGE SHANKS
SPEC: WALL MOUNTED HANDRINSE BASIN SINGLE CENTRAL TAPHOLE 48CM E1730 (PH: 01643490253)
- TAP** TRATTO SINGLE LEVEL MONOBLOCK MIXER, NO WASTE CHROMIUM FINISH
MANF: ARMATAGE SHANKS
SPEC: A6230AA (PH: 01643490253)
- SOP** CONCEALED LIQUID SOAP DISPENSER
MANF: HARBRINE
SPEC: SATIN STAINLESS STEEL CODE: 6.206
- TP** TOILET PAPER HOLDER
MANF: HARBRINE
SPEC: DOUBLE TOILET ROLL HOLDER SURFACE MOUNTED SATIN STAINLESS STEEL CODE: 6.025
- SBIN** SANITARY BIN
MANF: HARBRINE
SPEC: SATIN STAINLESS STEEL CODE: 6.040 (PH: 020 8980 8000)
- CH** DOOR MOUNTED COAT HOOK
MANF: HARBRINE
SPEC: STAINLESS STEEL CH CODE: 8.100 (PH: 020 8980 8000)
- DH** DOOR HANDLE
MANF: HARBRINE
SPEC: SATIN STAINLESS STEEL TEXTURED CODE: 1.186 (PH: 020 8980 8000)
- CDH** CUPBOARD DOOR HANDLE
MANF: HARBRINE
SPEC: SATIN STAINLESS STEEL CODE: 1.180 (PH: 020 8980 8000)
- PTD** STAINLESS STEEL PAPER TOWEL DISPENSER
MANF: HARBRINE
SPEC: SATIN STAINLESS STEEL CODE: 6.060 (PH: 020 8980 8000)
- MIR** 8mm TOUGHENED SAFETY GLASS MIRROR

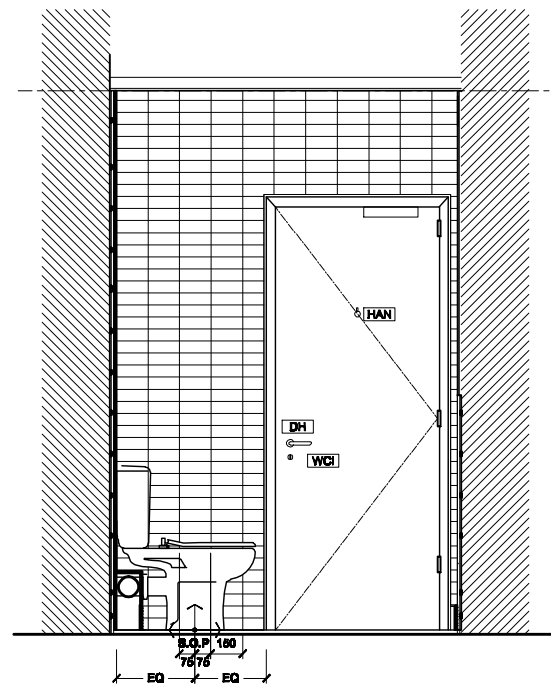

(4) ELEVATION WC 1:25

(B) PLAN KITCHENETTE UNIT 1:25

(5) ELEVATION TEA POINT CUPBOARD WITH CUPBOARD UNITS ABOVE 1:25

(B) SECTION TEA POINT CUPBOARD WITH CUPBOARD UNITS ABOVE 1:25

Tom Gianni Architects

WEST ENTRANCE - SECOND FLOOR
1-3 DUFFERIN STREET, LONDON EC1Y 8NA


020 7638 1226
020 7638 1227
www.tgarch.co.uk
info@tgarch.co.uk

NOTES:
XXXXXXXXXX

AS BUILT
MAR '07

ALL DIMENSIONS TO BE VERIFIED BY THE CONTRACTOR ON SITE.
ALL DIMENSIONS IN MILLIMETERS
ANY DISCREPANCIES TO BE REPORTED TO THE ARCHITECT IMMEDIATELY.
DO NOT SCALE FROM DRAWING.

© Tom Gianni Architects

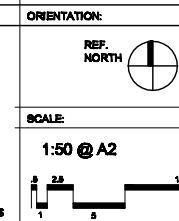

DRAWN BY:
RDR
CHECKED BY:
PVG
PROJECT No:
00633.00

CLIENT:
SERGIO ROSSI
PROJECT ADDRESS:
207 SLOANE STREET
LONDON
SW1X 9QX

DRAWING TITLE:
WC & TEA POINT PLANS,
INTERNAL ELEVATIONS &
SECTIONS
DRAWING No:
REV No:
EL-2.1
AS BUILT -