

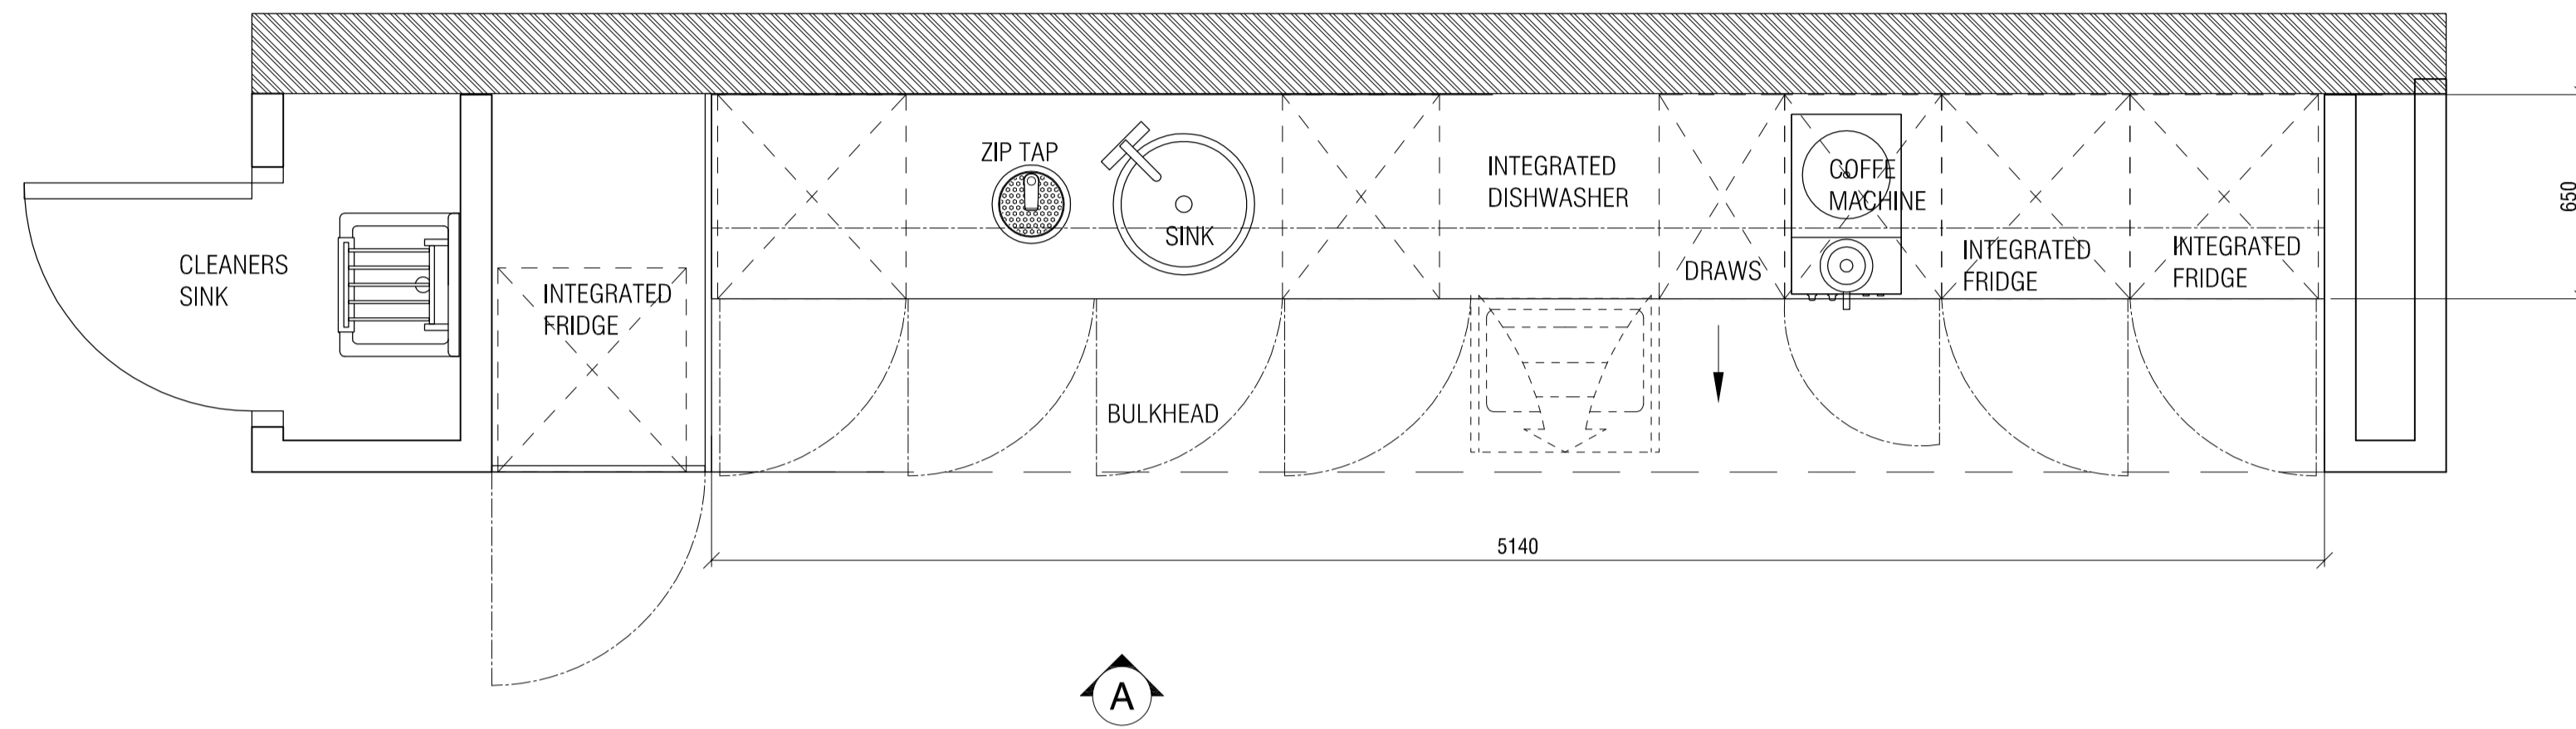


SUBJECT TO SITE SURVEY
CHECK SURVEY UNDERTAKEN ONLY
BUILDING PARAMETERS TAKEN FROM DRAWINGS PROVIDED
BUILDING PARAMETERS TAKEN FROM AS BUILT DRAWINGS PROVIDED

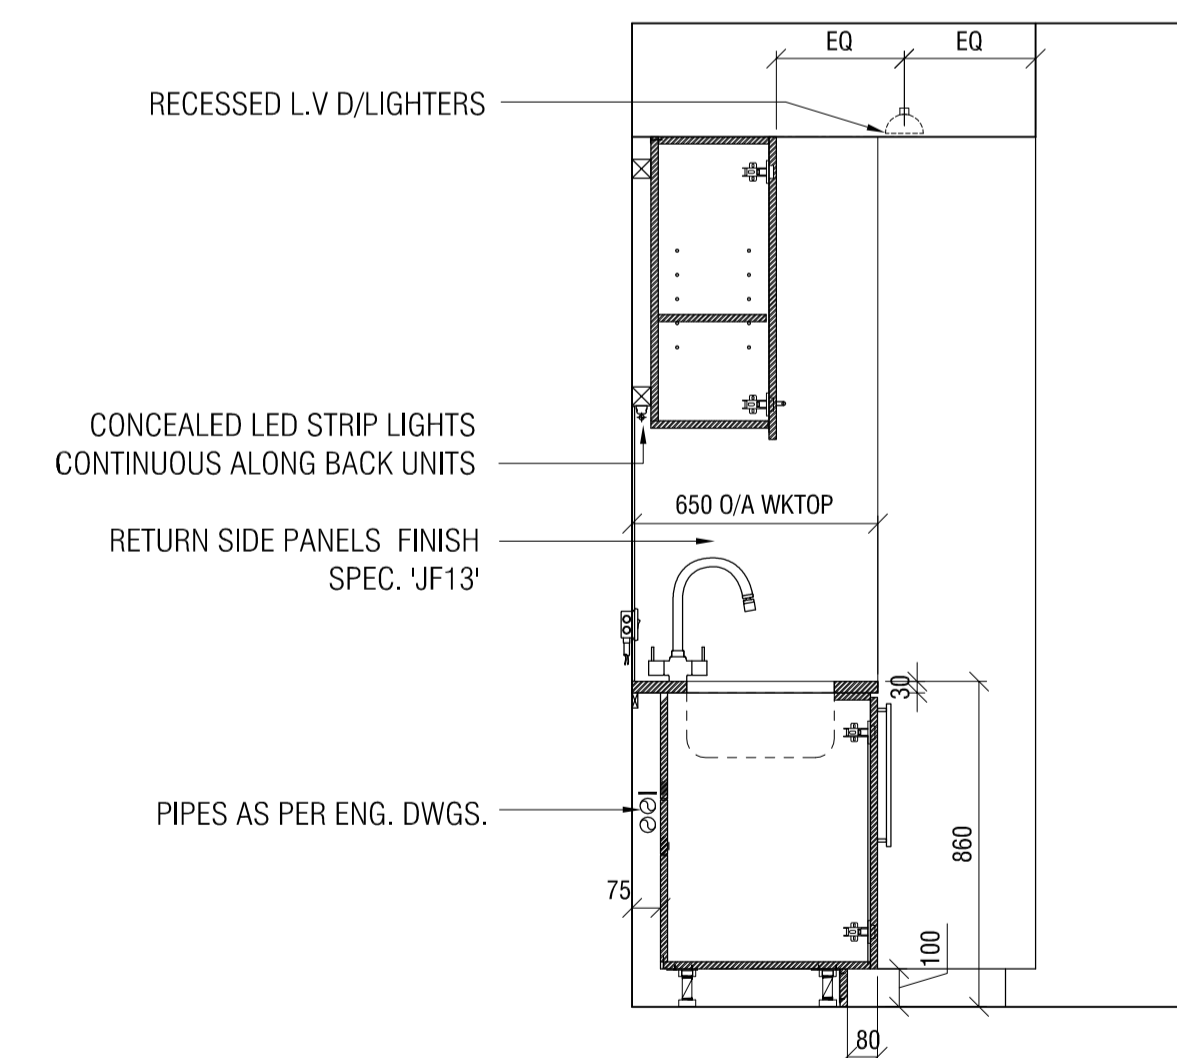

PLAN
SCALE 1:20

IMAGE
SCALE (NTS)

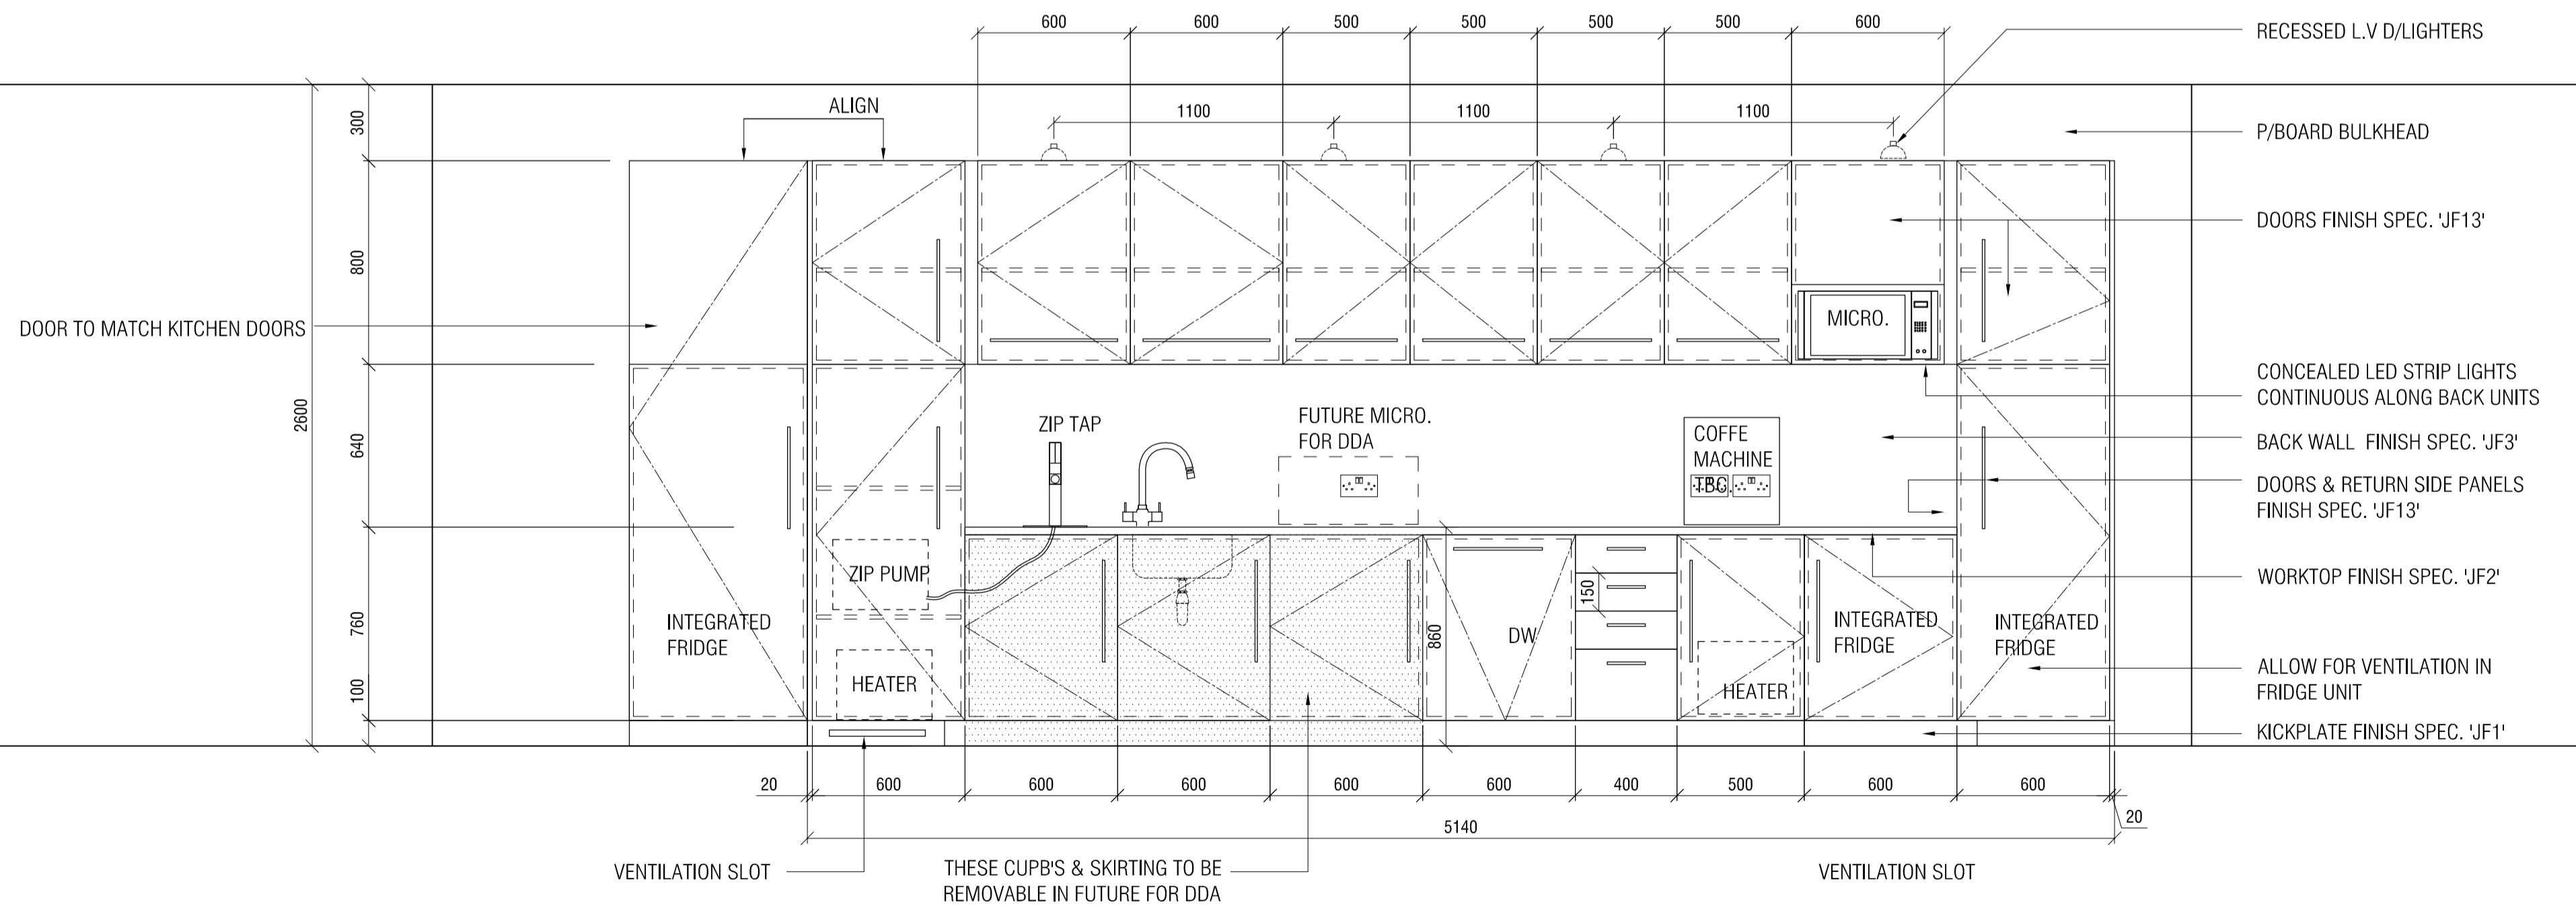

ELEVATION
SCALE 1:20

SECTION
SCALE 1:20

AS-BUILT			
Rev	Revision	By	Date
AB	AS-BUILT DRAWING		21.06.13

Morgan Lovell
Inspiring office transformation

16 Noel Street London W1F 6DA
T: 0207 734 4466 F: 0207 734 2968 E: contact@morganlovell.com
W: http://www.morganlovell.com

Client
INTUIT

Project
ONE CATHEDRAL PIAZZA
LONDON

Title
**PROPOSED 1ST FLOOR
TEA POINT DETAILS**

Scale 1:20@A1	Date 25.02.13	Designer/Drawn By VM/SB	Checked By / Date
------------------	------------------	----------------------------	-------------------

Drawing Number

Project No.	Floor	Drawing No.	Rev
ML0991		600	AB