



**PLAN**  
SCALE 1:20

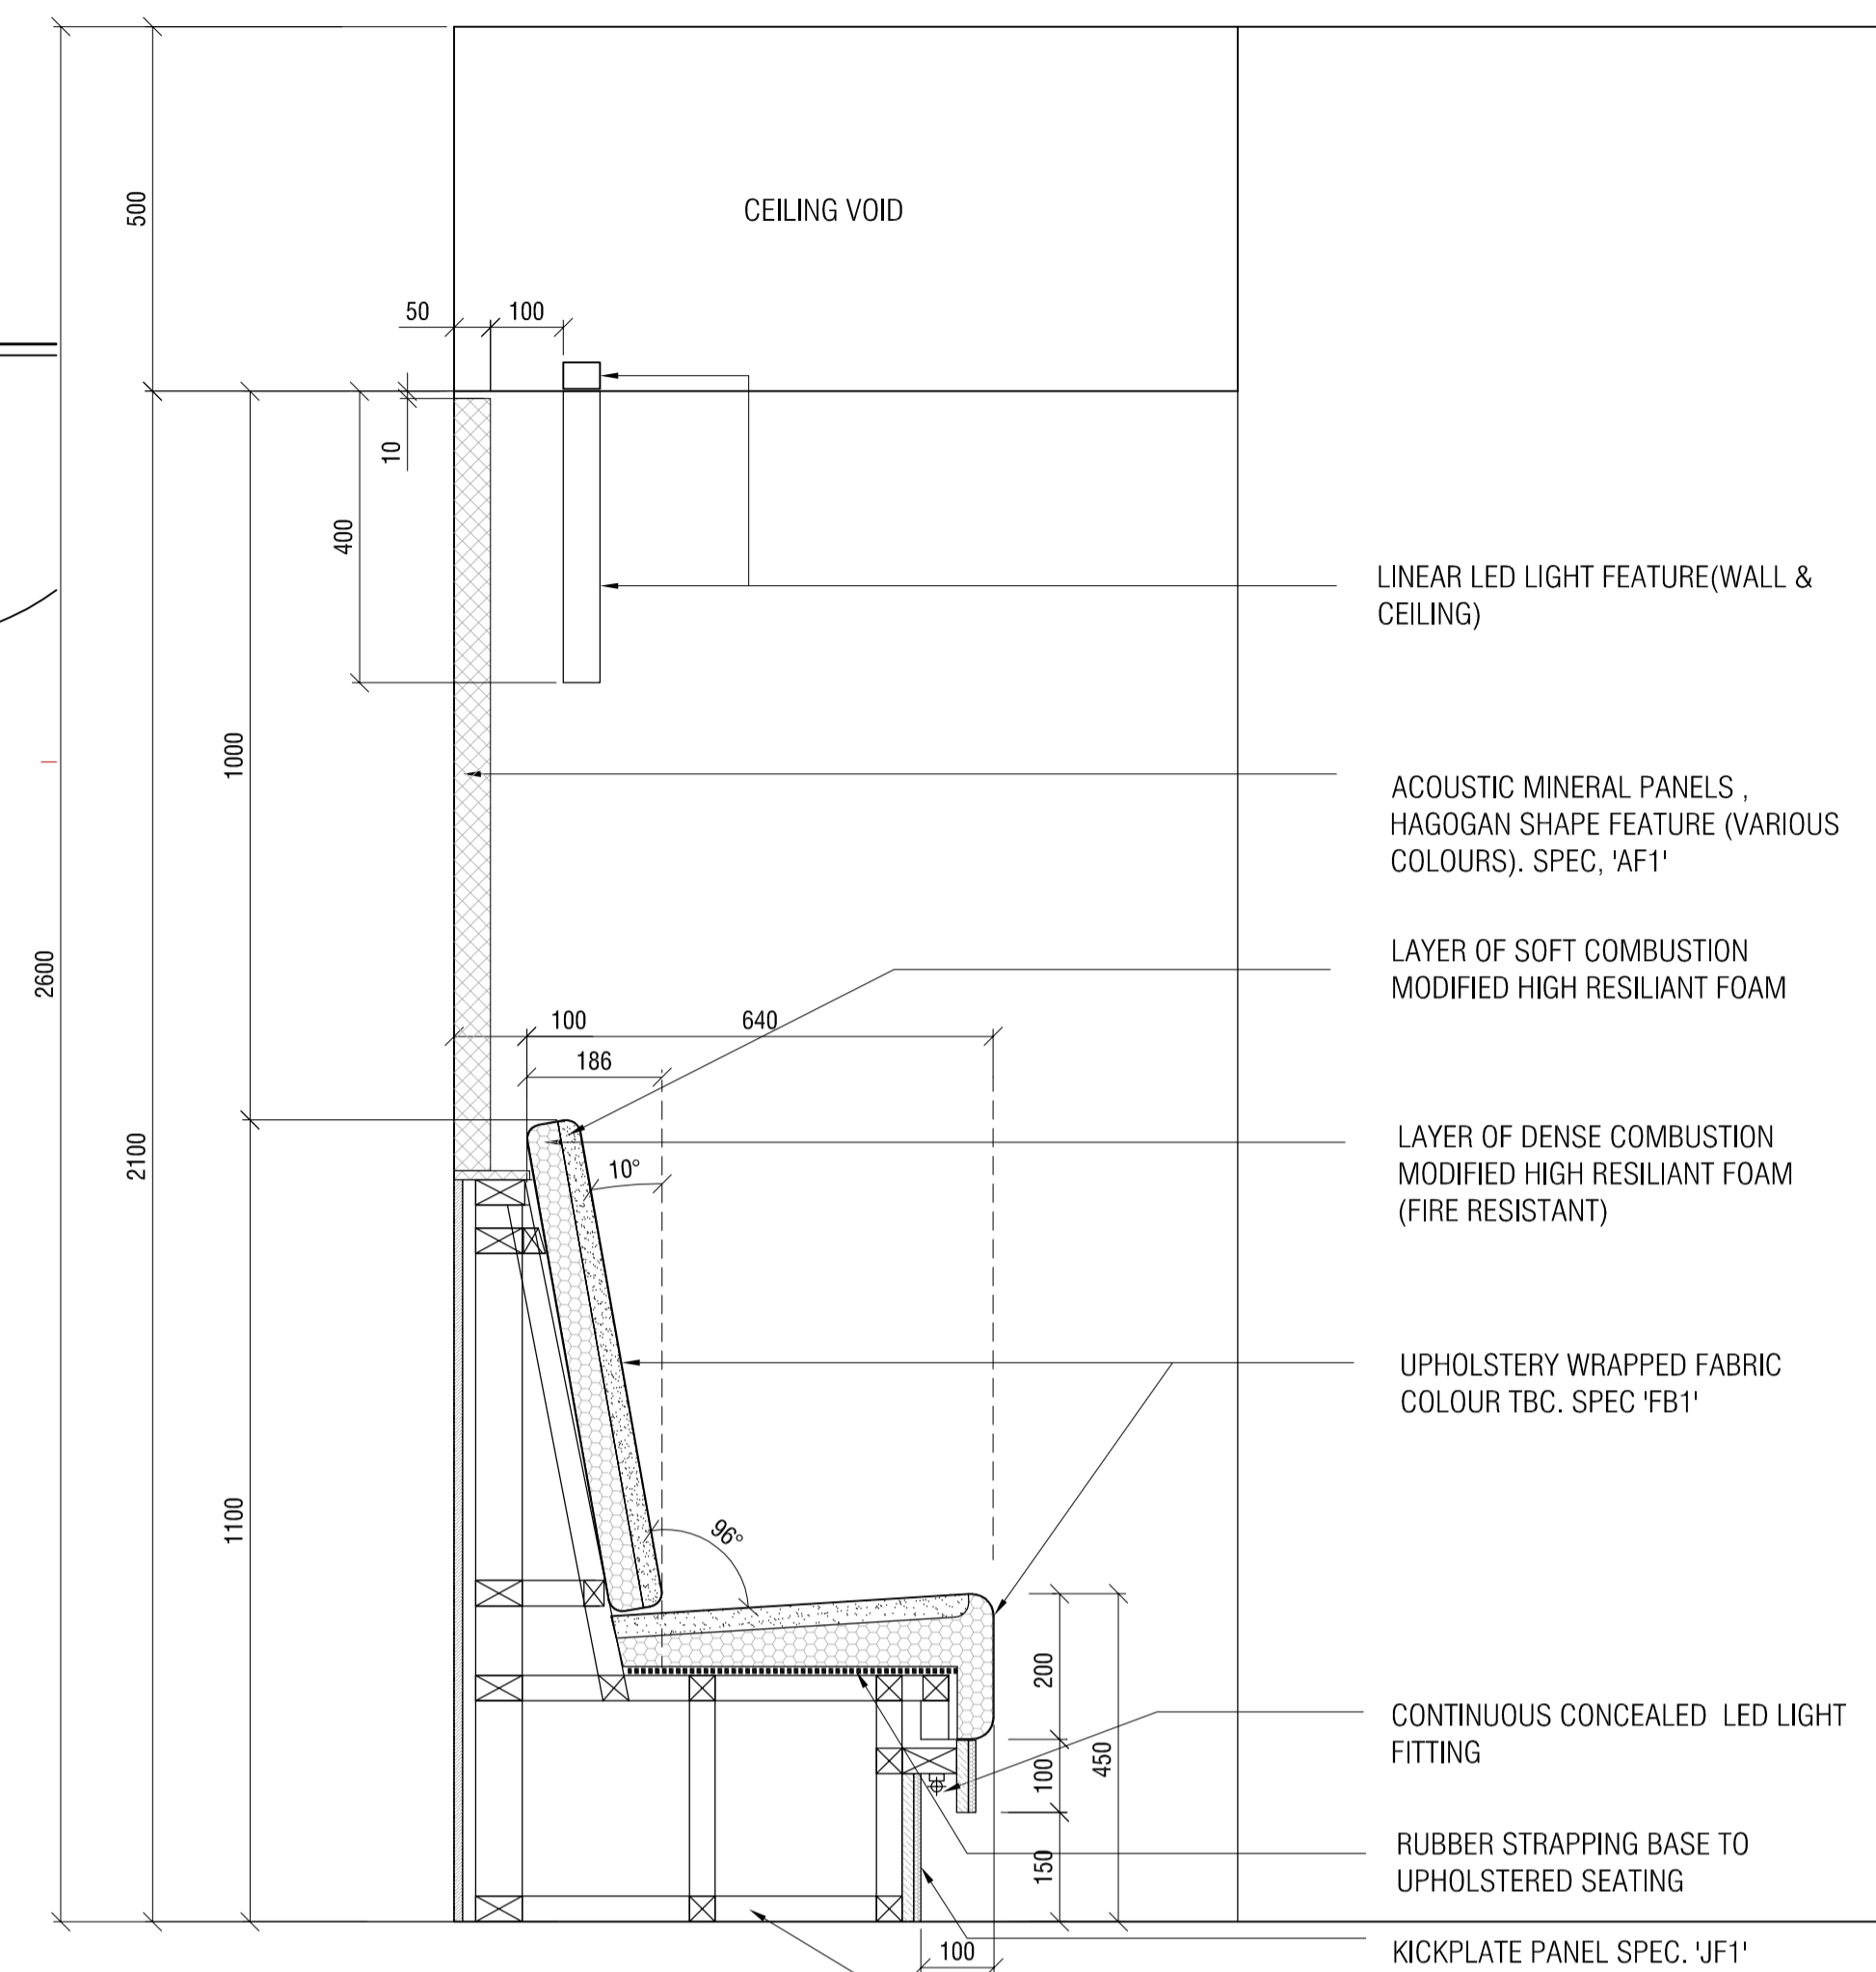

**1 SECTION**  
SCALE 1:10

SUBJECT TO SITE SURVEY  
CHECK SURVEY UNDERTAKEN ONLY  
BUILDING PARAMETERS TAKEN FROM DRAWINGS PROVIDED  
BUILDING PARAMETERS TAKEN FROM AS BUILT DRAWINGS PROVIDED

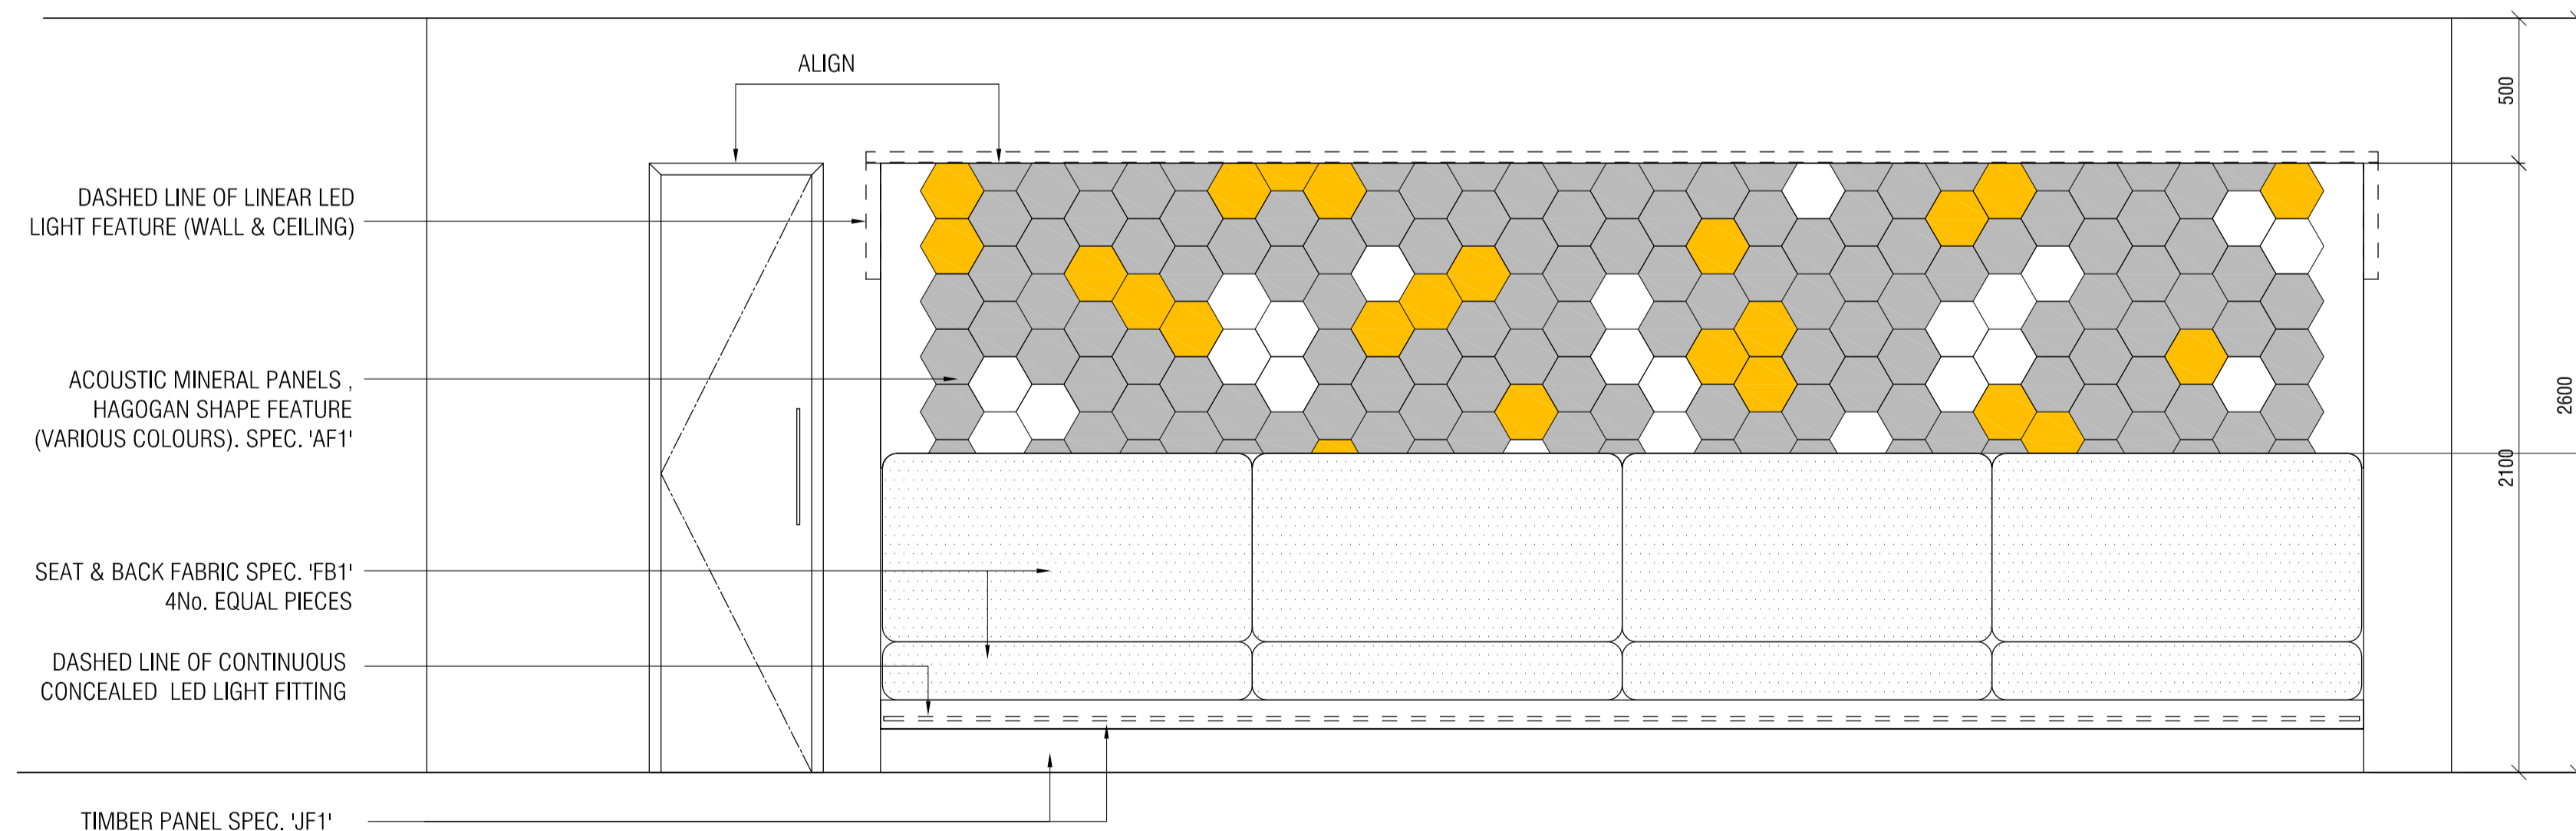

**A ELEVATION**  
SCALE 1:20



**IMAGE**  
SCALE (NTS)

**AS-BUILT**

Rev	Revision	By	Date
AB	AS-BUILT DRAWING		12.03.13

Rev	Revision	By	Date

**Morgan Lovell**  
Inspiring office transformation

16 Noel Street London W1F 6DA  
T: 0207 734 4468 F: 0207 734 2968 E: contact@morganlovell.com  
W: http://www.morganlovell.com

Client  
**INTUIT**

Project  
ONE CATHEDRAL PIAZZA  
LONDON

Title  
**PROPOSED 2ND FLOOR  
BANQUETTE SEATING DETAILS**

Scale	Date	Designer/Drawn By	Checked By / Date
1:20@A1	25.02.13	VM/SB	

Drawing Number			
Project No.	Floor	Drawing No.	Rev
ML0991	-	603	AB