

SEE PLAN FOR ROTATION ANGLE OF GRAPHIC. FLOOR & CEILING IMAGE TO BE SAME ANGLE & SIZE
 Note: Manufacturer to use EPS artwork supplied by client via ML.

This drawing is protected under Copyright and at no time must any portion of this drawing be reproduced or copied in anyway without the permission of Morgan Lovell.
 All dimensions must be checked on site and NOT scaled from this drawing.

SUBJECT TO SITE SURVEY
 CHECK SURVEY UNDERTAKEN ONLY
 BUILDING PARAMETERS TAKEN FROM DRAWINGS PROVIDED
 BUILDING PARAMETERS TAKEN FROM AS BUILT DRAWINGS PROVIDED



IMAGE REFERENCE
 SCALE NTS

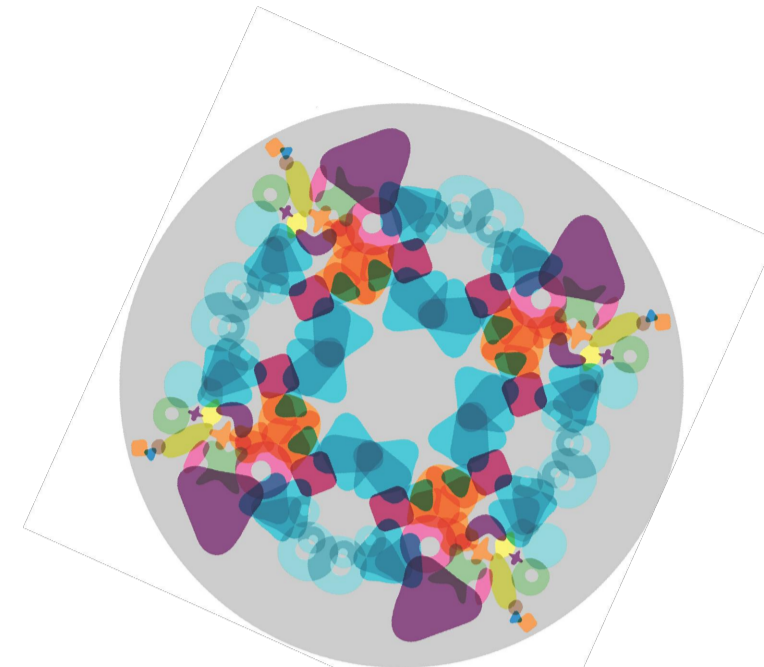


IMAGE FLOOR GRAPHICS (80% OPACITY)
 SCALE NTS


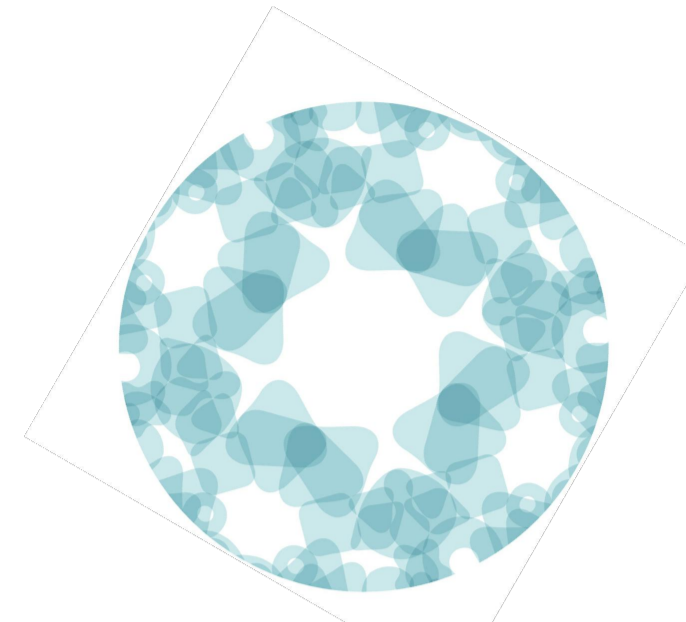


IMAGE CEILING GRAPHICS(80% OPACITY)
 SCALE NTS

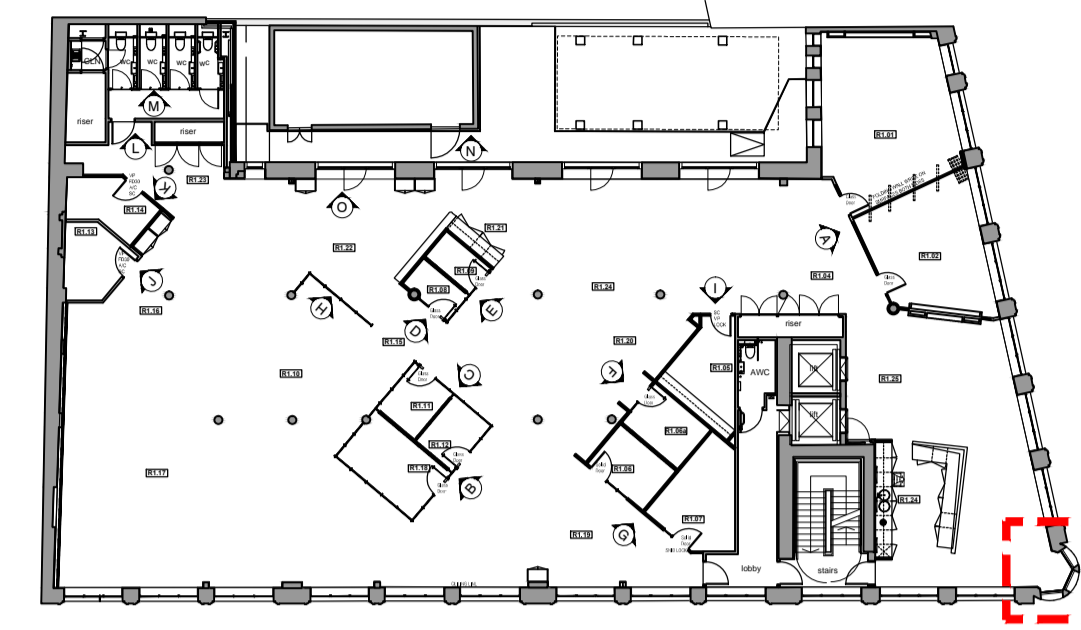

KEY PLAN
 NTS

NOTE:- SEE FINISHES SCHEDULE FOR SPECIFICATION



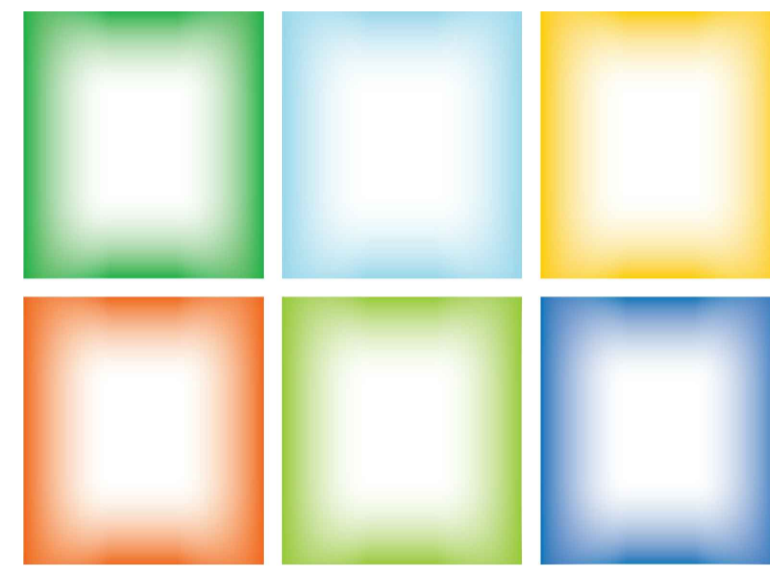


IMAGE REFERENCE FOR WINDOWS
 SCALE NTS

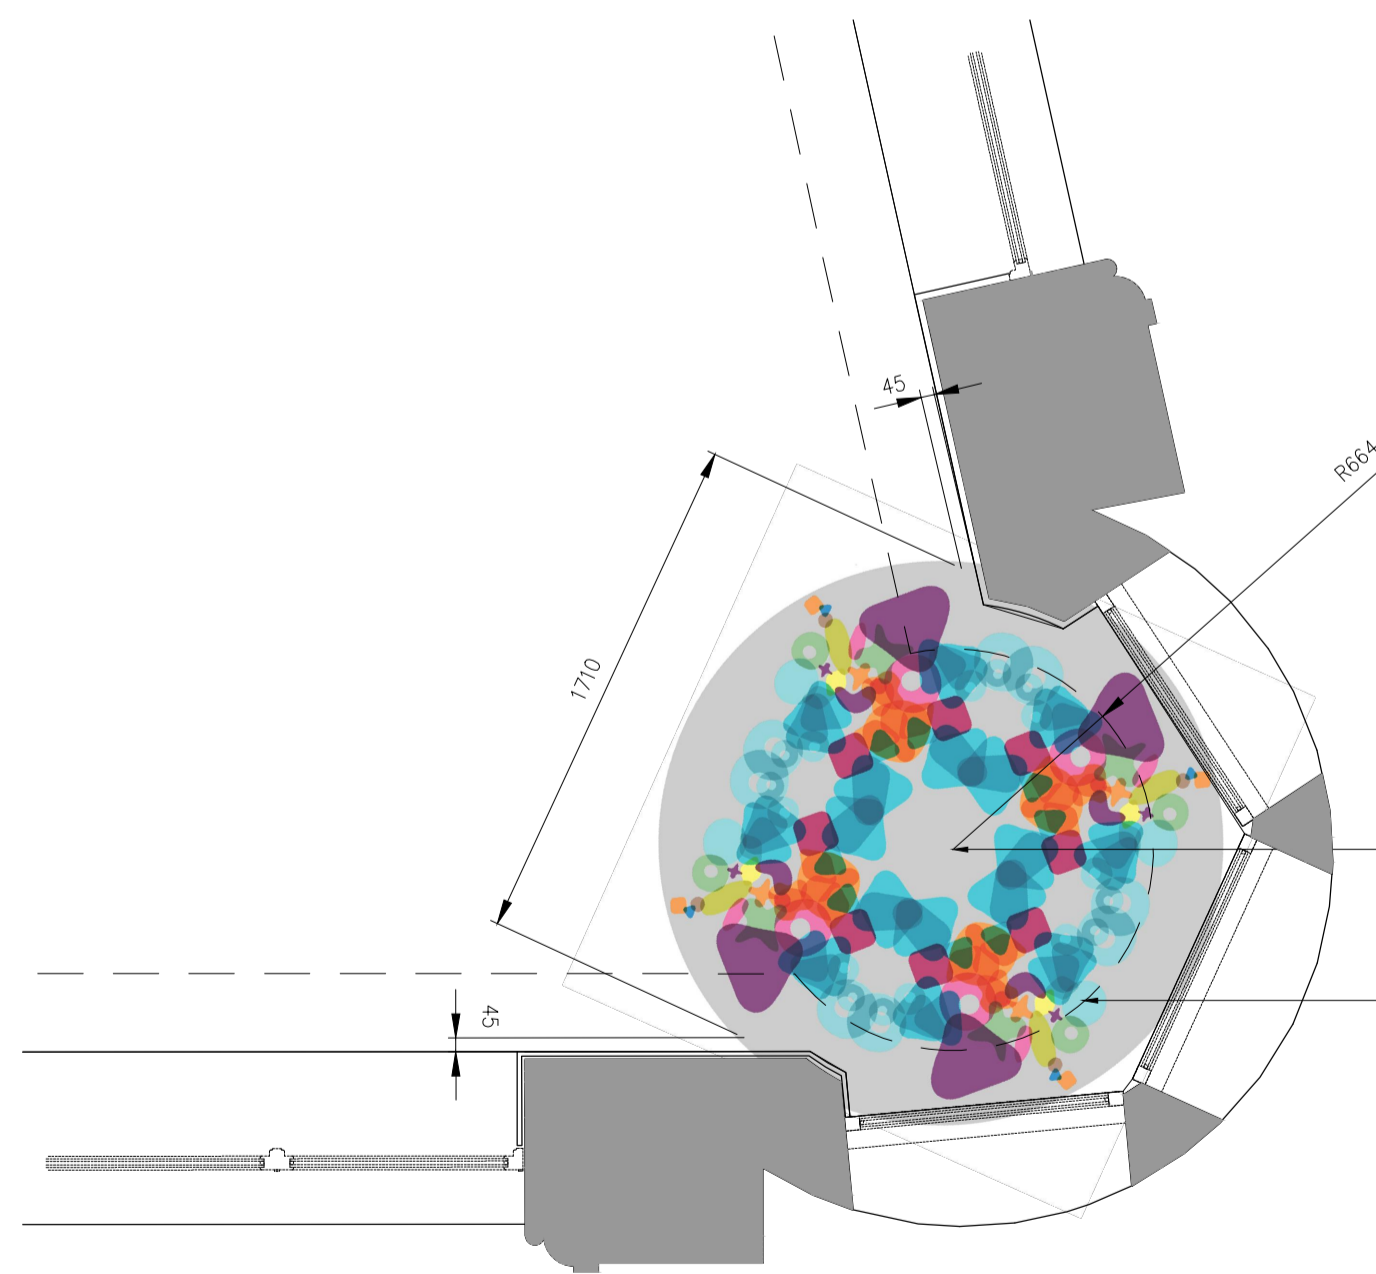

PLAN - FLOOR
 SCALE 1:25

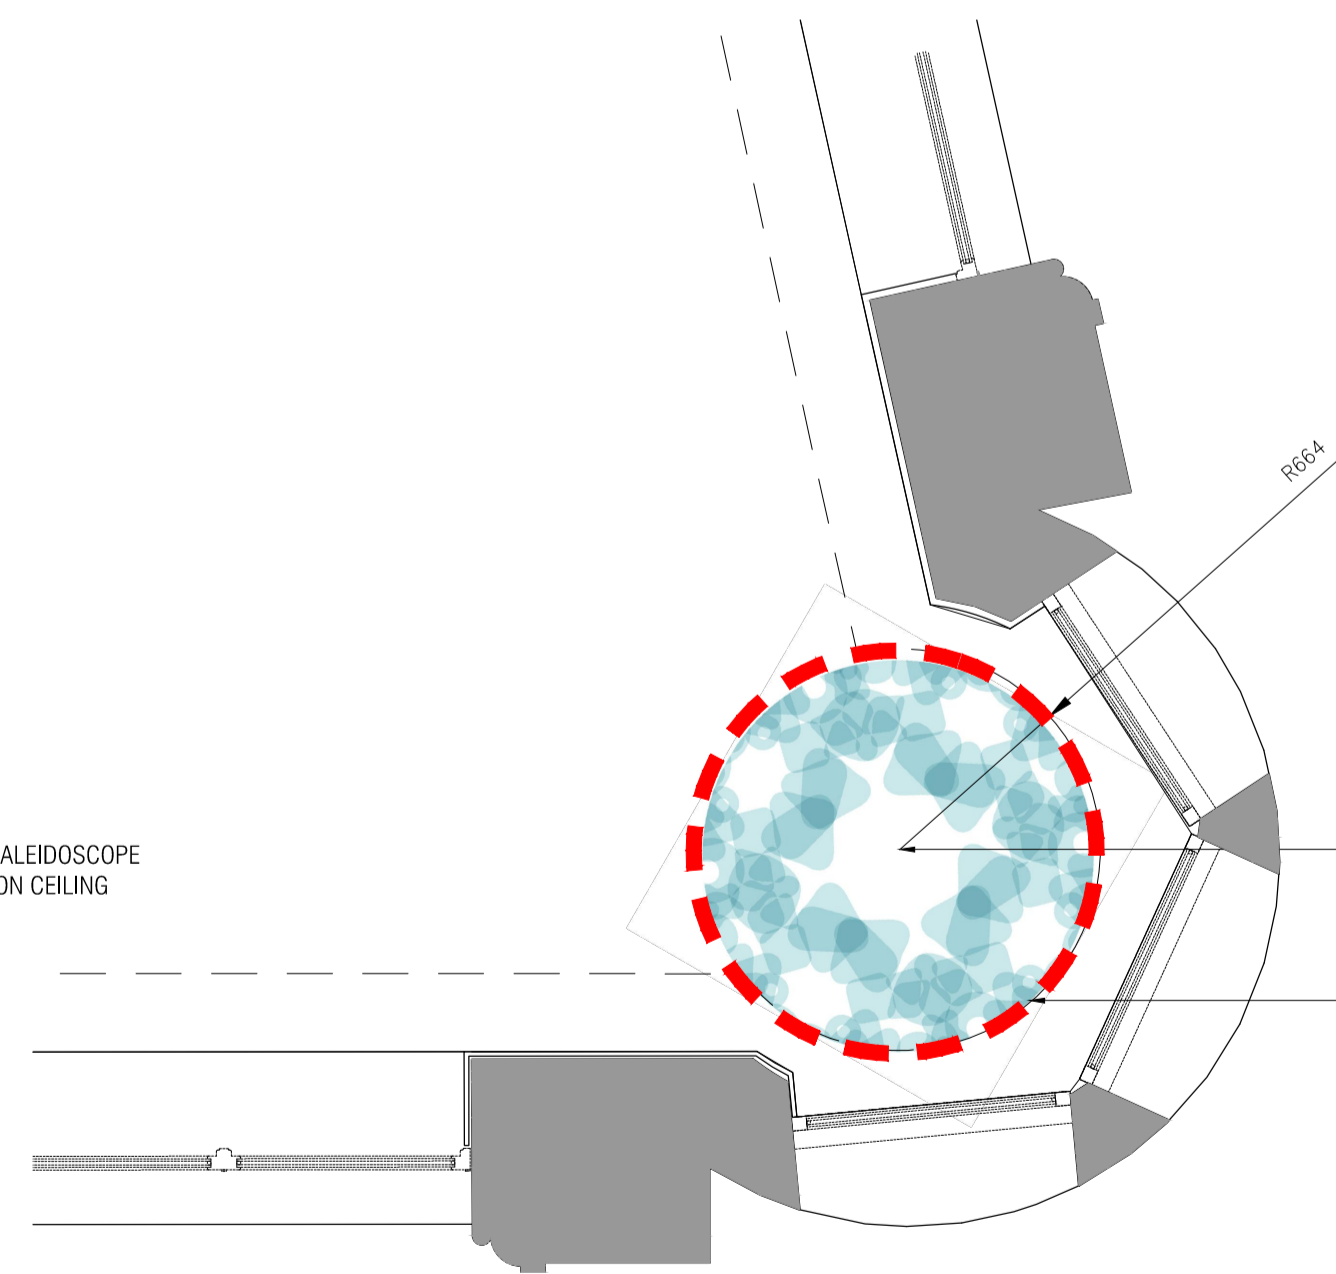

PLAN - RCP
 SCALE 1:25

PLAN - WALLS
 SCALE 1:25

RECORD DRAWING

AB	RECORD DRAWING	LT	27.11.14
Rev	Revision	By	Date

Morgan Lovell
 Inspiring office transformation

16 Noel Street London W1F 8DA
 T: 0207 734 4466 F: 0207 734 2968 E: contact@morganlovell.com
 W: http://www.morganlovell.com

Client
Thoughtworks

Project
 76-88 Wardour Street
 London

Title
**First Floor
 Kaleidoscope Graphics Floor / Ceiling**

Scale	Date	Designer/Drawn By	Checked By / Date
1:25 @ A1	Sep 2014	MC/VM	

Drawing Number			
Project No.	Floor	Drawing No.	Rev
ML1380	01	613	AB