

(NO NEON SIGN) (NO NEON SIGN)

Mayfair Soho Westminster Knightsbridge

Greenwich
Battersea

Camden
Stratford


Shoreditch

(NO NEON SIGN - ALL BELOW)
CALGARY
CAMBRIDGE
IRVINE
LONDON
MONTREAL

Brixton


(NO NEON SIGN)
VIENNA

(NO NEON SIGN)
SOFIA

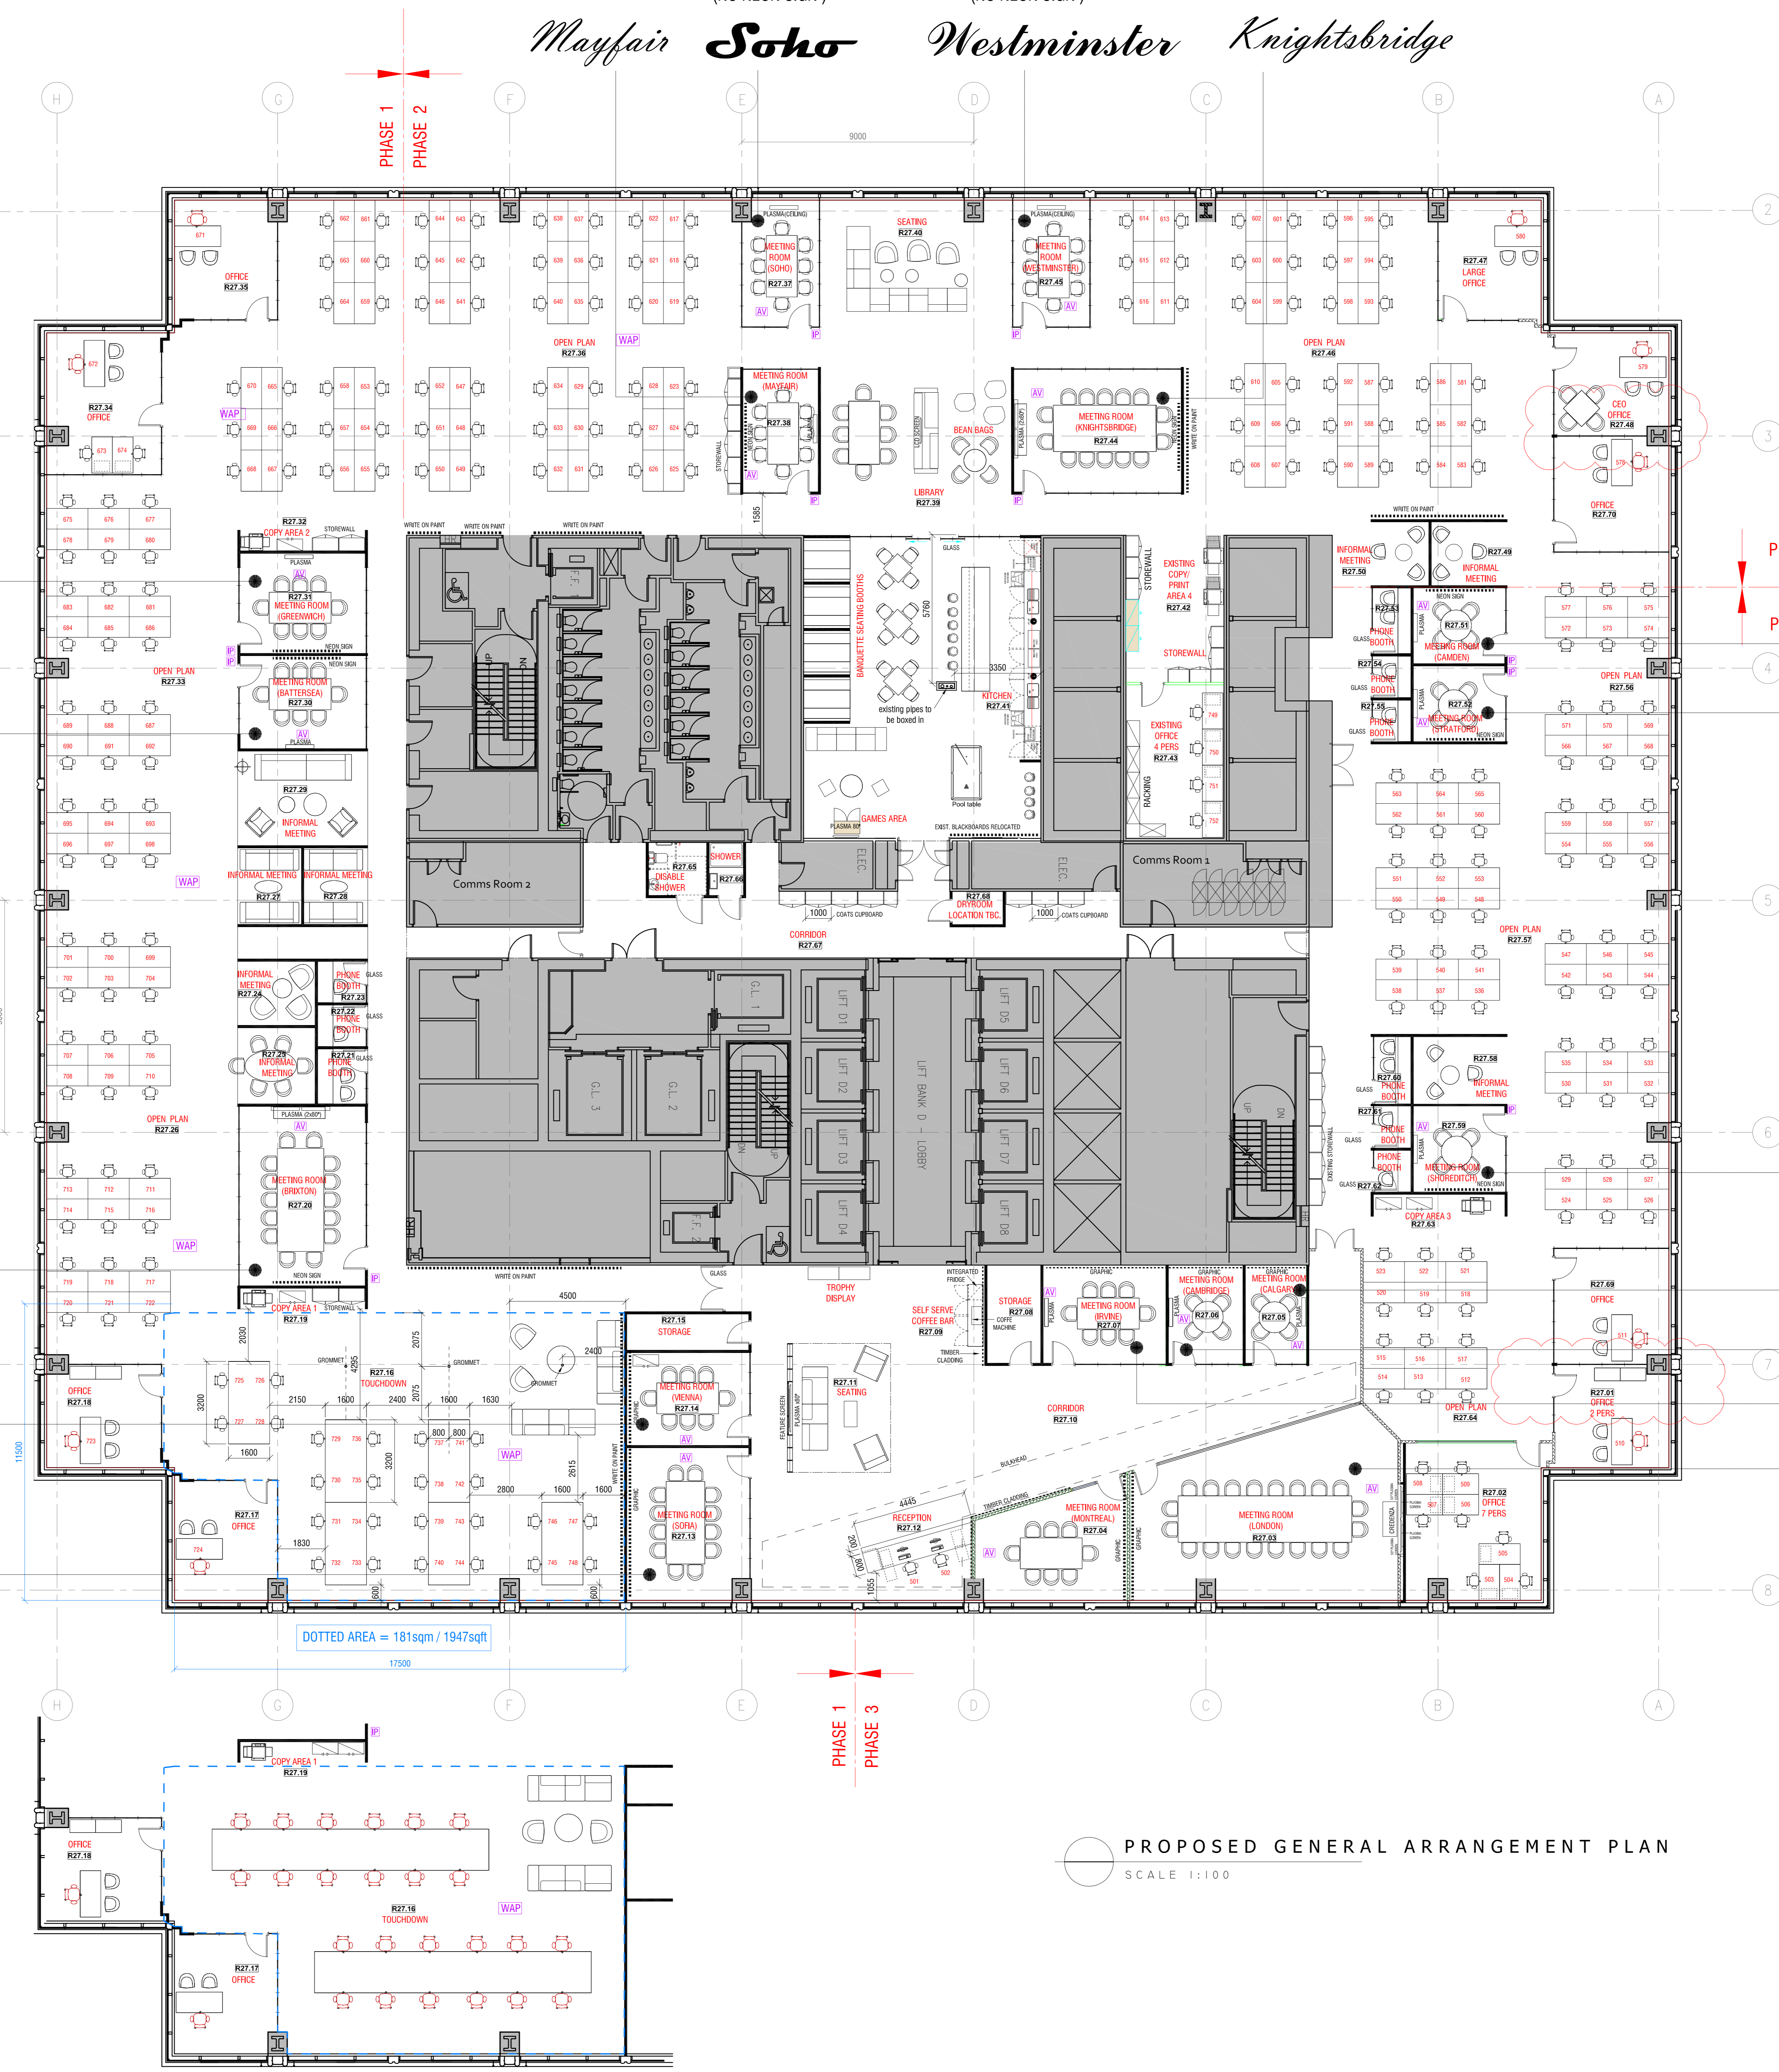

PROPOSED DAY 2
SCALE 1:100

PROPOSED GENERAL ARRANGEMENT PLAN
SCALE 1:100

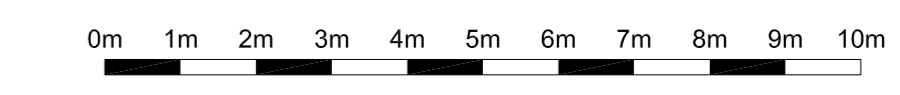

This drawing is protected under Copyright and at no time must any portion of this drawing be reproduced or copied in any way without the permission of Morgan Lovell.
All dimensions must be checked on site and NOT scaled from this drawing.


SUBJECT TO SITE SURVEY
CHECK SURVEY UNDERTAKEN ONLY
BUILDING PARAMETERS TAKEN FROM DRAWINGS PROVIDED
BUILDING PARAMETERS TAKEN FROM AS BUILT DRAWINGS PROVIDED

KEY - AUDIO VISUAL

- AV AUDIO VISUAL
- IPAD ROOM BOOKING SYSTEM
- WAP WIRELESS ACCESS POINT. ML, ML TO INSTALL CABLE FROM POINTS TO COMMS ROOM 2. CAT6 CABLES. (FULL TEST REQUIRED).

NOTES:

- DESK REQUIREMENTS ON 'LETTER' POWER DRAWINGS. EACH DESK TO HAVE 4No. POWER + 2No. DATA ON FLOOR.
- IPAD - ML TO RUN CABLE TO EACH IPAD POWER ONLY WITH LOCAL SPUR

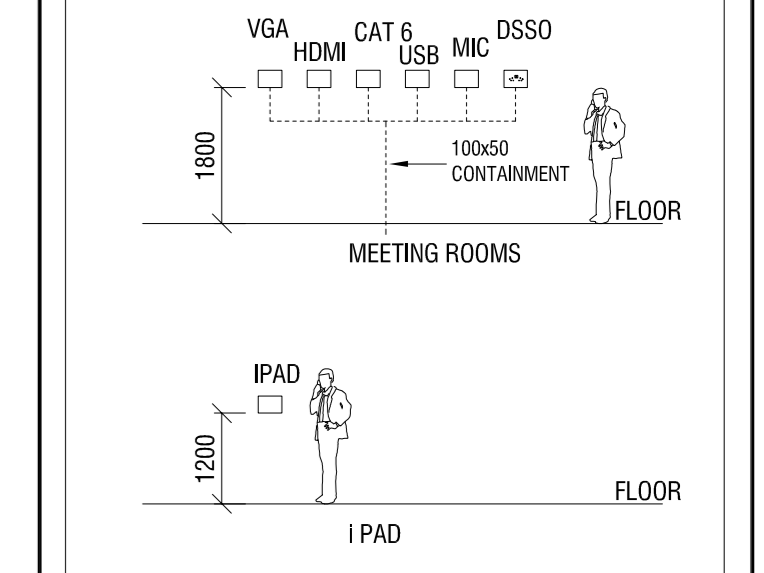

O	ROOM R27.48 & R27.01 WALLS CHANGED TO GLASS	VM	14.04.16
N	GRAMMETS IN R27.16 INDICATED	VM	08.04.16
M	ABLE WORKING AREA REMOVED	VM	29.03.16
L	ABLE WORKING AREA REMOVED	VM	23.03.16
K	2No. TROPHY DISPLAY UNITS ADDED IN RECEPTION. EXISTING STOREROOMS OPPOSITE ROOM R27.01 RETAINED	VM	15.03.16
J	KNIGHTSBRIDGE & MAYFAIR MEETING ROOMS RENTED. RECEPTION REMOVED TO NEW	VM	25.02.16
I	DOORS ADDED IN PHONE BOOTHS. CREDENTIALS ROOM R27.14 & R27.07 CHANGING ARRANGED AT POOL TABLE	VM	05.02.16
H	ROOMS R27.49 & R27.58 PARTITION WALLS REMOVED. REVISIONS AS CLOUSED FOR FURNITURE. COATS ADDED	VM	01.02.16
G	ALL OFFICES ALONG OPEN LINE 5. MOVED TOWARDS BUILDING FACADE ONE TO EXISTING CORNER WALL WARDER	VM	25.01.16
F	CREDENTIALS ADDED IN KITCHEN & EXISTING BACK BOARD	VM	18.01.16
E	NEON SIGNS ADDED. EXISTING COPERS RETAINED. STOREROOM WALLS WIPED ON SURFACE ADDED	VM	11.11.15
D	WRITE ON GLASS NOTES REMOVED FROM CORNER OFFICES	CP	11.12.15
C	ALL OFFICE SOLID WALLS REMOVED & ADDED GLASS & MEETING ROOM R27.4 & R45. ADDED TWO NEW OFFICES R89 & R70. 2No. DESK ACCESS ROOMS	VM	19.11.15
B	REMOVED FILING IN OPEN PLAN & INCREASE SPACE DESKS	VM	13.11.15
A	REVISED TO LATEST COST PLAN	VM	11.11.15
REV	FIRST ISSUE	VM	23.10.15
Rev	Revision	Rev	Draw

CONSTRUCTION

Morgan Lovell

10 Noel Street, London, W1F 8EA
T: 0207 734 4466 F: 0207 734 2969 E: contact@morganlovell.com W: http://www.morganlovell.com

OPTIMAL PAYMENTS

Client
Project
25 CANADA SQUARE
LONDON
E14 5LB

Title
27TH FLOOR
PROPOSED PLAN

Scale 1:100(BA) Date 23.10.2015 Designer/Drawn By VM/JM Checked By VM

Drawing Number			
Project No.	Floor	Drawing No.	Rev
ML1922	27	100	0