
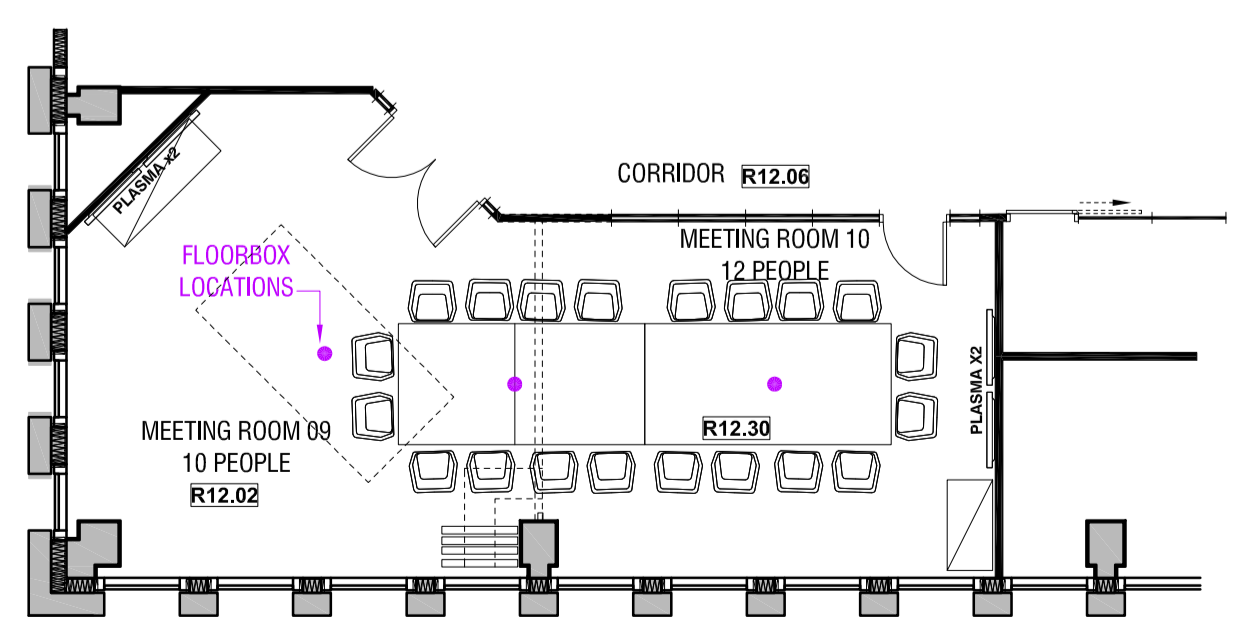


This drawing is protected under Copyright and at no time must any portion of this drawing be reproduced or copied in anyway without the permission of Morgan Lovell.

All dimensions must be checked on site and NOT scaled from this drawing.

SUBJECT TO SITE SURVEY
 CHECK SURVEY UNDERTAKEN ONLY
 BUILDING PARAMETERS TAKEN FROM DRAWINGS PROVIDED
 BUILDING PARAMETERS TAKEN FROM AS BUILT DRAWINGS PROVIDED

NOTES:
 1. ALL OPEN PLAN AREA TV SCREENS ARE ON CEILING POLE MOUNTED.
 2. PHOTO COPY LOCATIONS TO BE AGREED

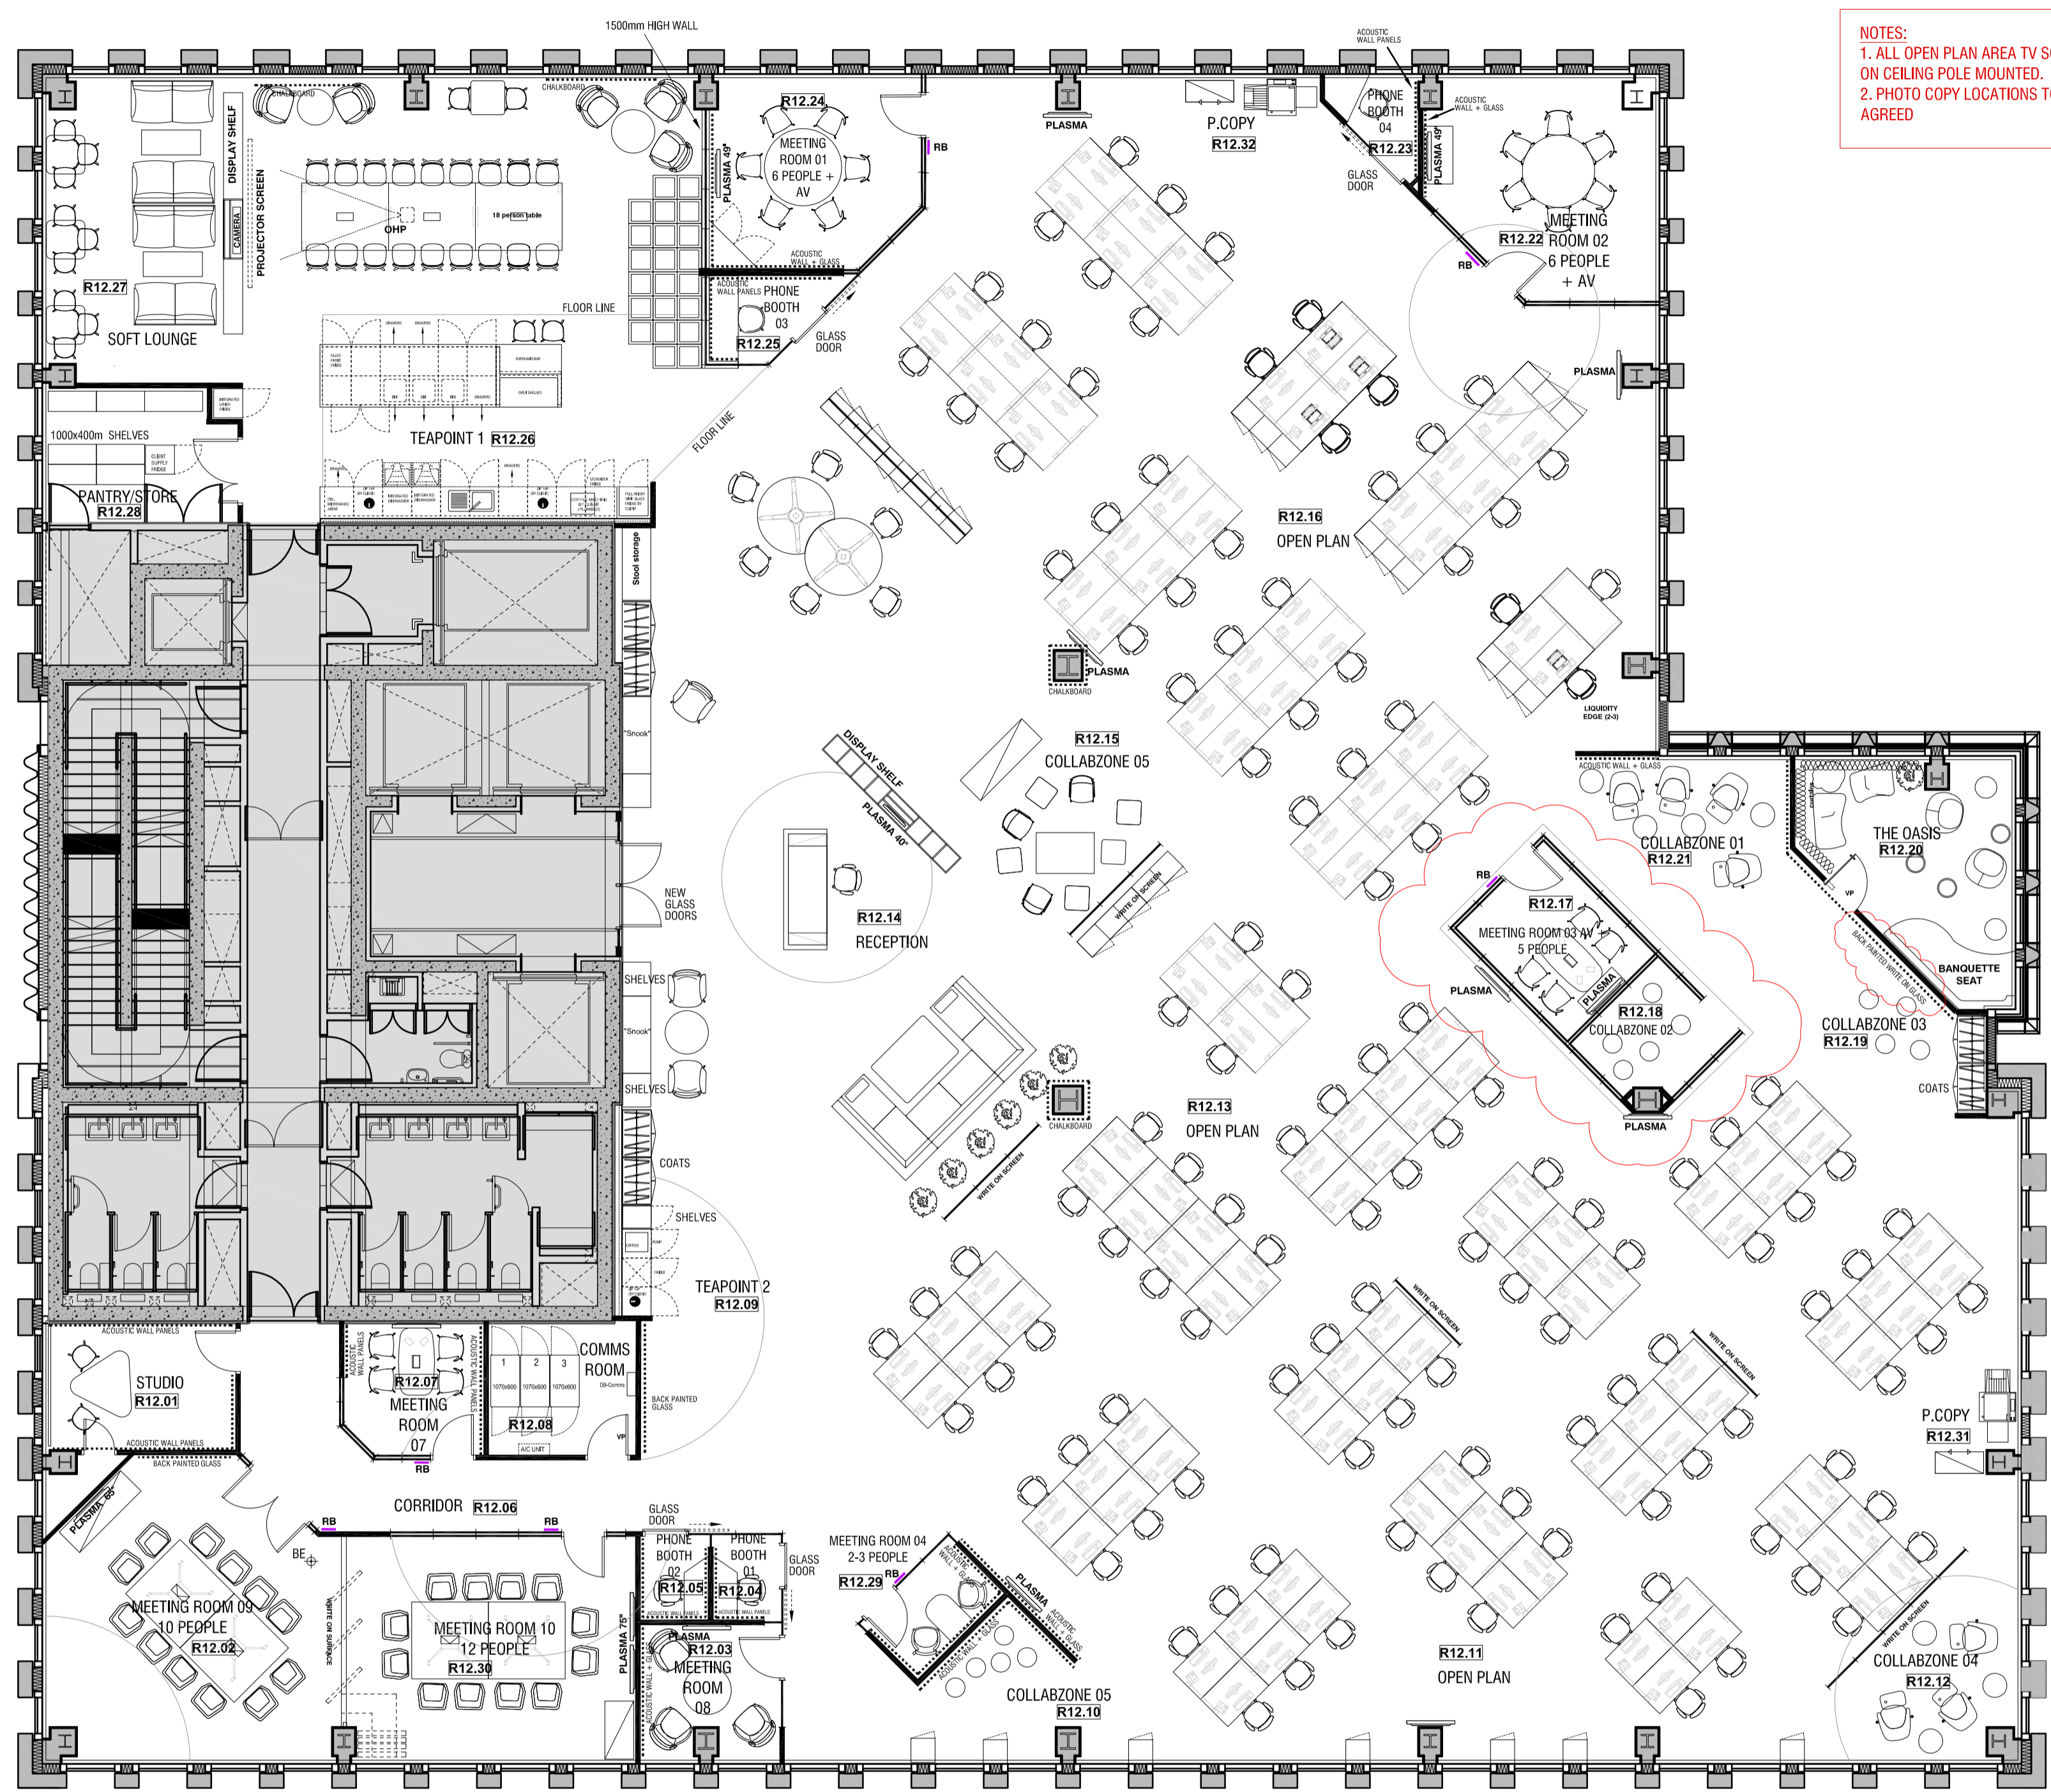

BOARD ROOM ALTERNATE PLAN

Rev	Revision	By	Date
G	ROOM R.12.17 & 18 REVISED	VM	02.11.17
F	COMMS ROOM REVISED. ADDED ROOM BOOKINGS & FRIDGE	VM	25.10.17
E	DESIGN DEVELOPMENT	VM	26.09.17
D	DESIGN DEVELOPMENT	MP	11.09.17
C	DESIGN DEVELOPMENT LAYOUT	MP	23.08.17
B	REVISED PARTITION LAYOUT	MP	22.08.17
A	REVISED PARTITION LAYOUT	MP	10.08.17
-	FIRST ISSUE	MP	31.07.17

CONSTRUCTION

Morgan Lovell

16 Noel Street London W1F 8DA
 T: 0207 734 4466 F: 0207 734 2968 E: contact@morganlovell.com
 W: http://www.morganlovell.com

Client
R3

Project
 12th Floor
 2 London Wall Place
 EC2

Title
**12th floor
 Proposed Layout**

Scale	Date	Designer/Drawn By	Checked By / Date
1:100 @ A1	26.07.17	MP	-

Drawing Number			
Project No.	Floor	Drawing No.	Rev
ML2552	12	100	G

